

NOTES

FOR SPECIFICATION NOTES, REFER TO DRAWINGS S00.01 - S00.04.

THESE DRAWINGS SHALL BE READ IN CONJUNCTION WITH THE LATEST ARCHITECT'S DRAWINGS AND ANY RELEVANT CONSULTANT'S / CONTRACTOR'S DRAWINGS. IT IS THE BUILDERS RESPONSIBILITY TO ENSURE THE LATEST REVISION OF ALL DRAWINGS ARE BEING USED ON SITE.

CO-ORDINATE ALL SERVICE PENETRATION SIZES AND LOCATIONS WITH MECHANICAL, ELECTRICAL AND HYDRAULIC CONSULTANT'S DRAWINGS.

WHERE APPLICABLE, THE SLAB AND FOOTINGS HAVE BEEN DESIGNED IN ACCORDANCE WITH THE PRINCIPLES OF AS2870-2011 FOR CLASS 'M' SITE FOR ARTICULATED MASONRY VENEER EQUIVALENT CONSTRUCTION.

THE BUILDER IS TO ENGAGE A SUITABLY QUALIFIED GEOTECHNICAL ENGINEER TO CONFIRM THAT THE FOUNDING MATERIALS MEET THE FOLLOWING REQUIREMENTS PRIOR TO PLACING OF REINFORCEMENT:

- ALLOWABLE BEARING CAPACITY
- COMPACTION LEVEL
- SITE CLASSIFICATION

LEGEND

DENOTES EXTENT AND SLAB THICKNESS OF STIFFENED RAFT SLAB ON GROUND. REINFORCE WITH SL82 MESH TOP. CAST SLABS ON 0.2mm POLYTHENE MEMBRANE LAID OVER A NOMINAL LEVELLING LAYER OF SAND ON COMPACTED FILL or FIRM NATURAL GROUND

DENOTES STRUCTURAL SLAB STEP.

DENOTES DOWEL JOINT.

DENOTES 3-LIITM OR 3/N12 x 2000 LONG TRIMMER BARS TIED TO UNDERSIDE OF MESH AT ALL RE-ENTRANT CORNERS

DENOTES FALLS IN STRUCTURAL SLAB TO DRAINAGE, REFER ARCHITECTURAL CONCRETE SET-OUT PLANS FOR SPECIFICATION.

DENOTES PENETRATIONS/VOIDS IN SUSPENDED CONCRETE SLAB. PROVIDE TRIMMERS BARS TO EDGES.

DENOTES STRUCTURAL MEMBER OVER

DENOTES STRUCTURAL MEMBER UNDER

VERTICAL STRUCTURAL ELEMENTS WITHOUT A SUFFIX (+/O OR +/U) SHALL BE READ AS OVER & UNDER. REFER TO MEMBER SCHEDULE FOR ADDITIONAL INFORMATION.

- LOWER GROUND FLOOR SLAB SCHEDULE -		
MARK	SIZE	COMMENTS
CONCRETE BEAM		
EB1	300d x 2000w + 1200key	EDGE BEAM
EB2	400d x 300w	EDGE BEAM
EB3	400d x 1000w	EDGE BEAM
IB1	400d x 300w	INTERNAL BEAM
IB3	400d x 450w	INTERNAL BEAM
IB4	400d x 1400w	INTERNAL BEAM
LOAD-BEARING BLOCKWORK PIER		
BP1	190	
LOAD-BEARING BLOCKWORK WALL		
BW1	190	
RW1	190	RETAINING WALL
PAD FOOTING		
PF1	450d x 1600 x 1000	
PF3	500d x 1800sq.	

Sheet size: A1

Legend

Bulk Excavation

BW1 - 200 Series Block

Concrete Slab - 100mm THK

EB1 - 2000x300mm

EB2 - 400x300mm

EB3 - 400x1000mm


IB1 - 400x300mm

IB3 - 400x450mm

IB4 - 400x1400mm

PF1 - 450mm D

PF3 - 500mm D

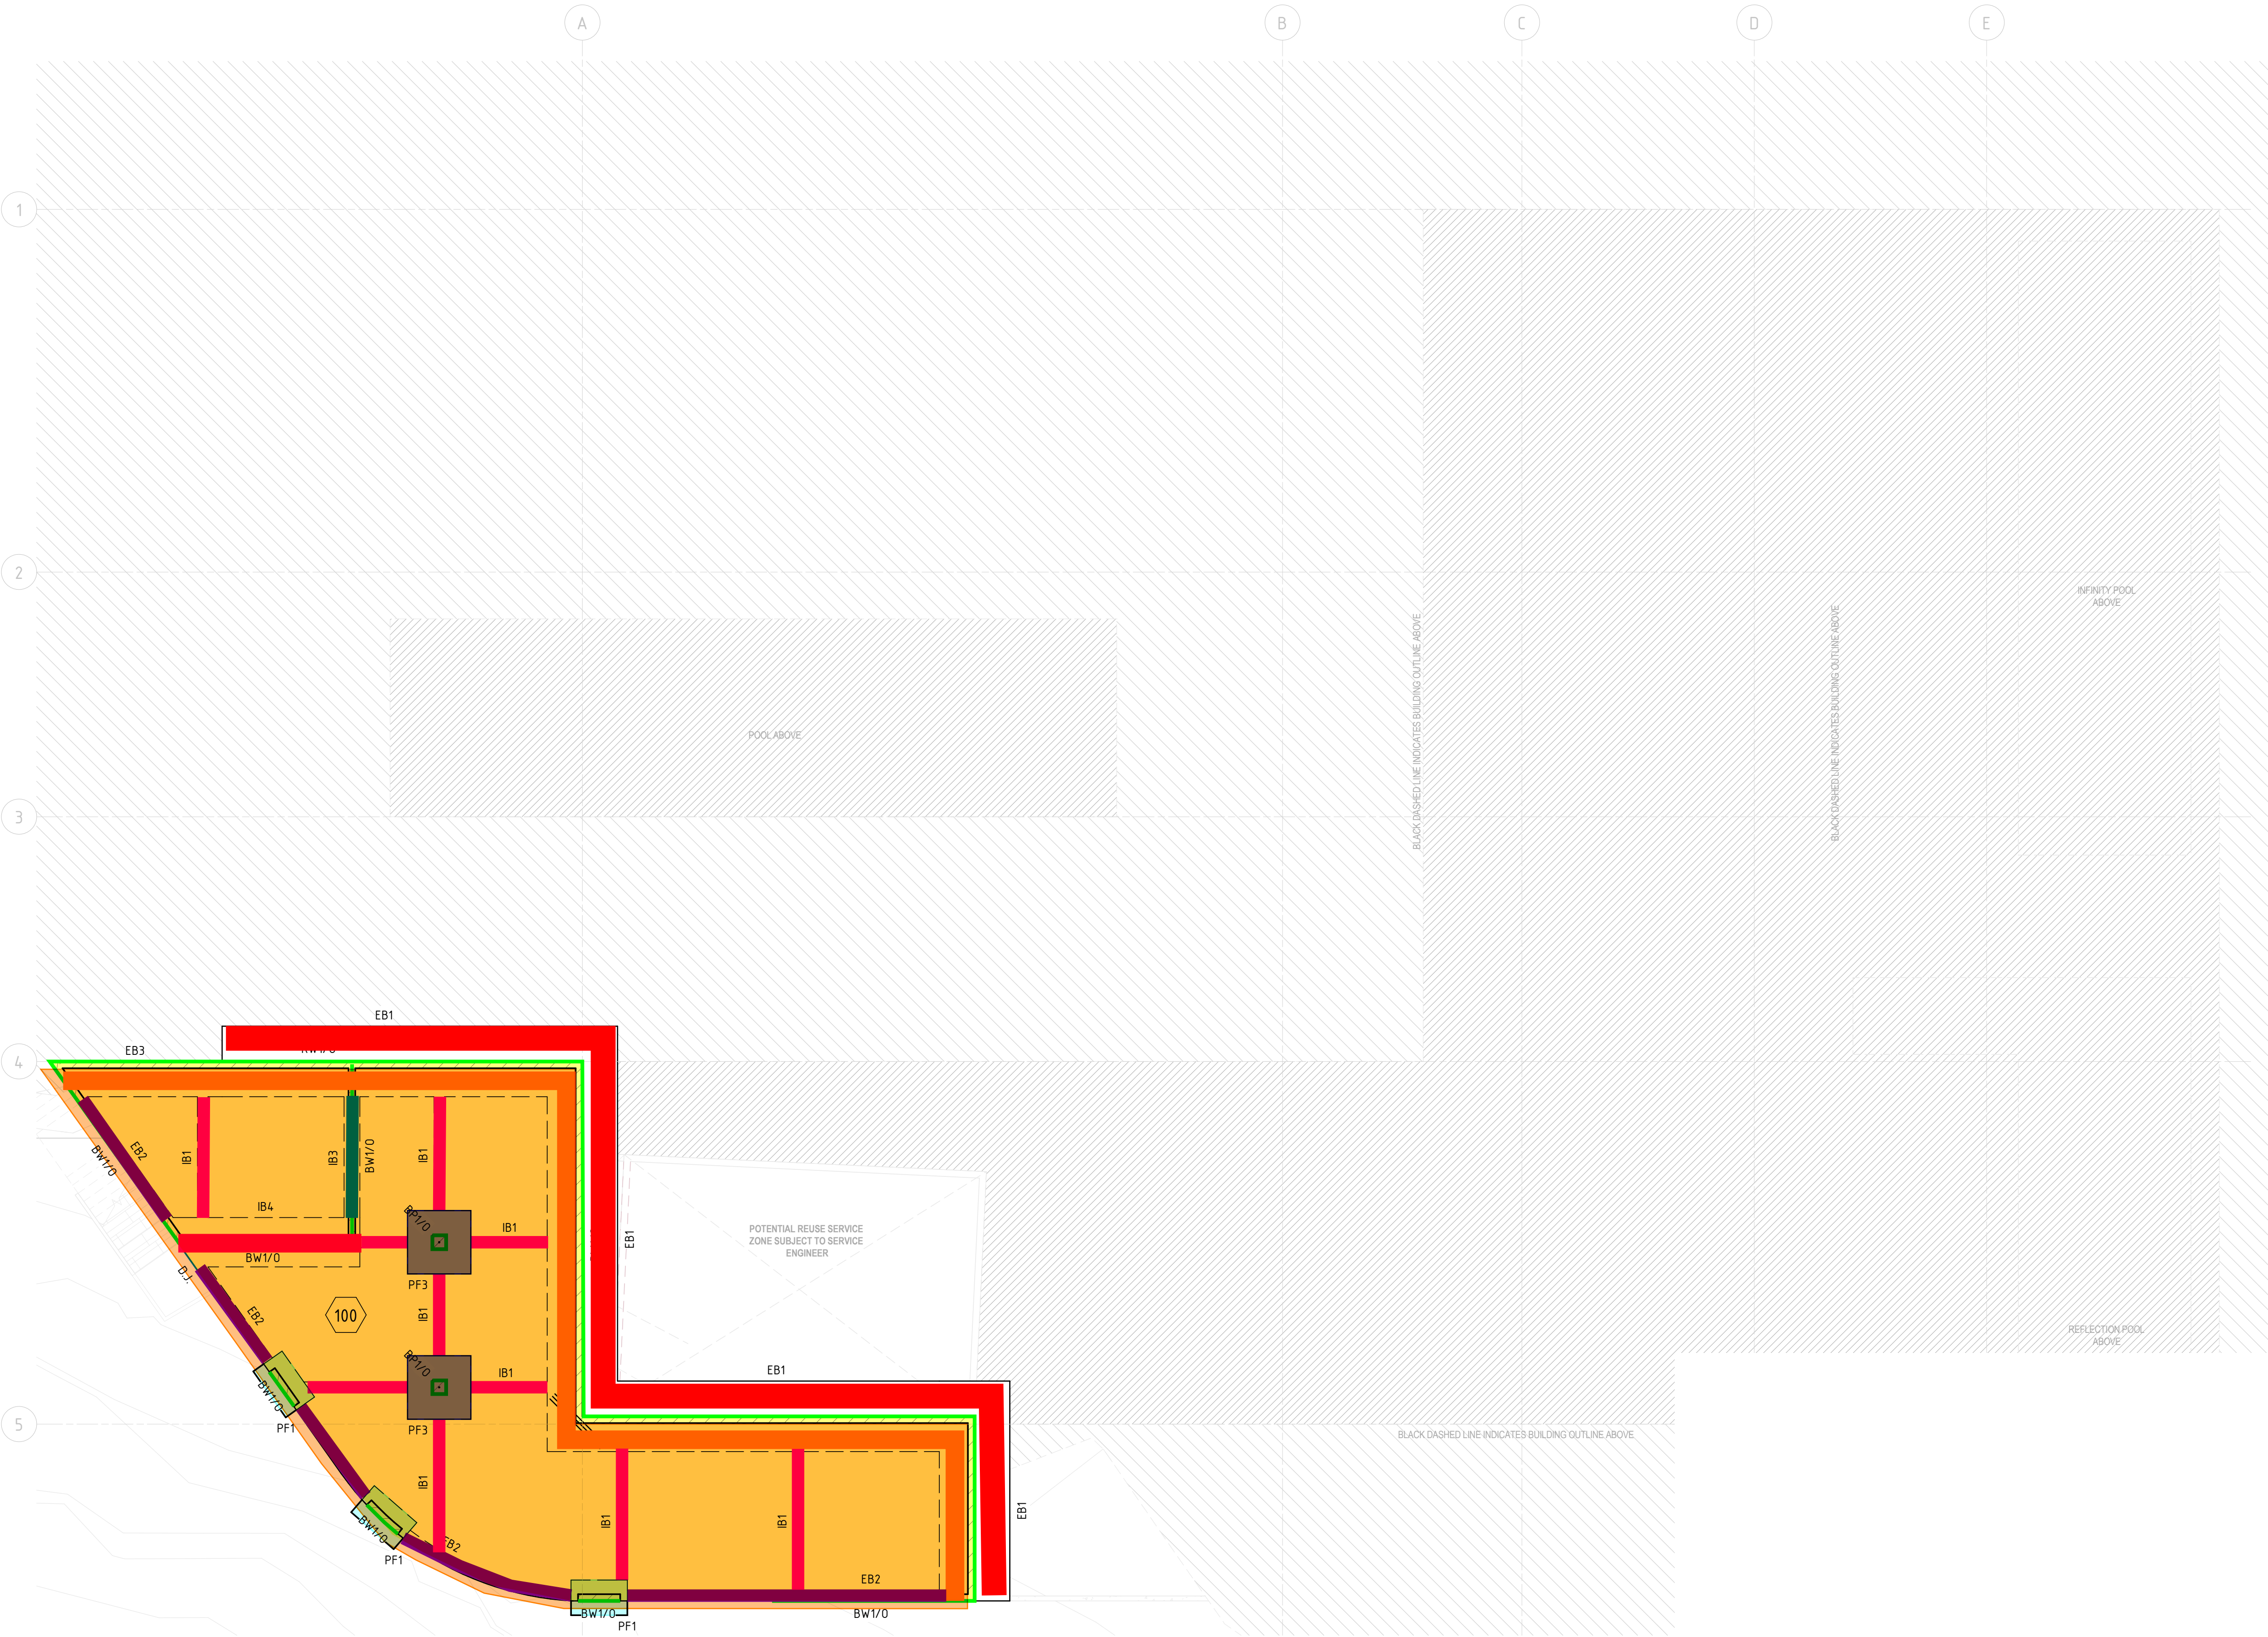

LOWER GROUND FLOOR SLAB PL

FOR SPECIFICATION NOTES, REFER TO DRAWINGS S00.01 - S00.04.

THESE DRAWINGS SHALL BE READ IN CONJUNCTION WITH THE LATEST ARCHITECT'S DRAWINGS AND ANY RELEVANT CONSULTANT'S / CONTRACTOR'S DRAWINGS. IT IS THE BUILDERS RESPONSIBILITY TO ENSURE THE LATEST REVISION OF ALL DRAWINGS ARE BEING USED ON SITE.

CO-ORDINATE ALL SERVICE PENETRATION SIZES AND LOCATIONS WITH MECHANICAL, ELECTRICAL AND HYDRAULIC CONSULTANT'S DRAWINGS.

WHERE APPLICABLE, THE SLAB AND FOOTINGS HAVE BEEN DESIGNED IN ACCORDANCE WITH THE PRINCIPLES OF AS2870-2011 FOR CLASS 'M' SITE FOR ARTICULATED MASONRY VENEER EQUIVALENT CONSTRUCTION.

THE BUILDER IS TO ENGAGE A SUITABLY QUALIFIED GEOTECHNICAL ENGINEER TO CONFIRM THAT THE FOUNDING MATERIALS MEET THE FOLLOWING REQUIREMENTS PRIOR TO PLACING OF REINFORCEMENT:

- ALLOWABLE BEARING CAPACITY
- COMPACTION LEVEL
- SITE CLASSIFICATION

 DENOTES SUSPENDED POST-TENSION SLAB THICKNESS. 40MPa.
ALLOW:
- INTERNAL; PT =
- EXTERNAL; PT =

100 DENOTES EXTENT AND SLAB THICKNESS OF STIFFENED RAFT SLAB ON GROUND. REINFORCE WITH SL82 MESH TOP. CAST SLABS ON 0.2mm POLYTHENE MEMBRANE LAID OVER A NOMINAL LEVELLING LAYER OF SAND ON COMPACTED FILL or FIRM NATURAL GROUND

100
MIN

DENOTES EXTENT OF 100mm THICK PAVEMENT SLAB. REINFORCE
SLAB WITH SL72 MESH TOP THROUGHOUT CAST. CAST OVER
0.2mm POLYTHENE MEMBRANE LAID OVER COMPACTED SUB-BASE.

 STEP DENOTES STRUCTURAL SLAB STEP.

D.J. / S.D.J. DENOTES DOWEL JOINT OR SLIDING DOWEL JOINT.


 DENOTES 3-LIITM OR 3/N12 x 2000 LONG TRIMMER BARS
 TIED TO UNDERSIOE OF MESH AT ALL RE-ENTRANT CORNERS

 DENOTES SETDOWN IN STRUCTURAL SLAB FOR WET AREAS.

 DENOTES FALLS IN STRUCTURAL SLAB TO DRAINAGE, REFER ARCHITECTURAL CONCRETE SET-OUT PLANS FOR SPECIFICATION.

 DENOTES PENETRATIONS/VOIDS IN SUSPENDED CONCRETE SLAB.
PROVIDE TRIMMERS BARS TO EDGES.


G.T.D. DENOTES GRATED TRENCH DRAIN, REFER CIVIL FOR SPECIFICATION.

 DENOTES LOAD-BEARING STRUCTURAL ELEMENT.

* / O	DENOTES STRUCTURAL MEMBER OVER
* / U	DENOTES STRUCTURAL MEMBER UNDER


	Bulk Excavation
	CC1 - 250mm THK
	Concrete Slab - 100mm THK
	Concrete Slab - 220mm THK
	EB2 - 400x300mm
	EB3 - 400x1000mm
	EB5 - 400x1400mm
	EB6 - 500x1200mm
	IB1 - 400x300mm
	IB4 - 400x1400mm
	IB5 - 500x2200mm
	PF2 - 450mm D
	PF3 - 500mm D
	PF4 - 550mm D
	PF5 - 500mm D
	PF6 - 500mm D
	SF1 - 500x1200mm

TO OR */U) SHALL BE READ
ADDITIONAL INFORMATION.

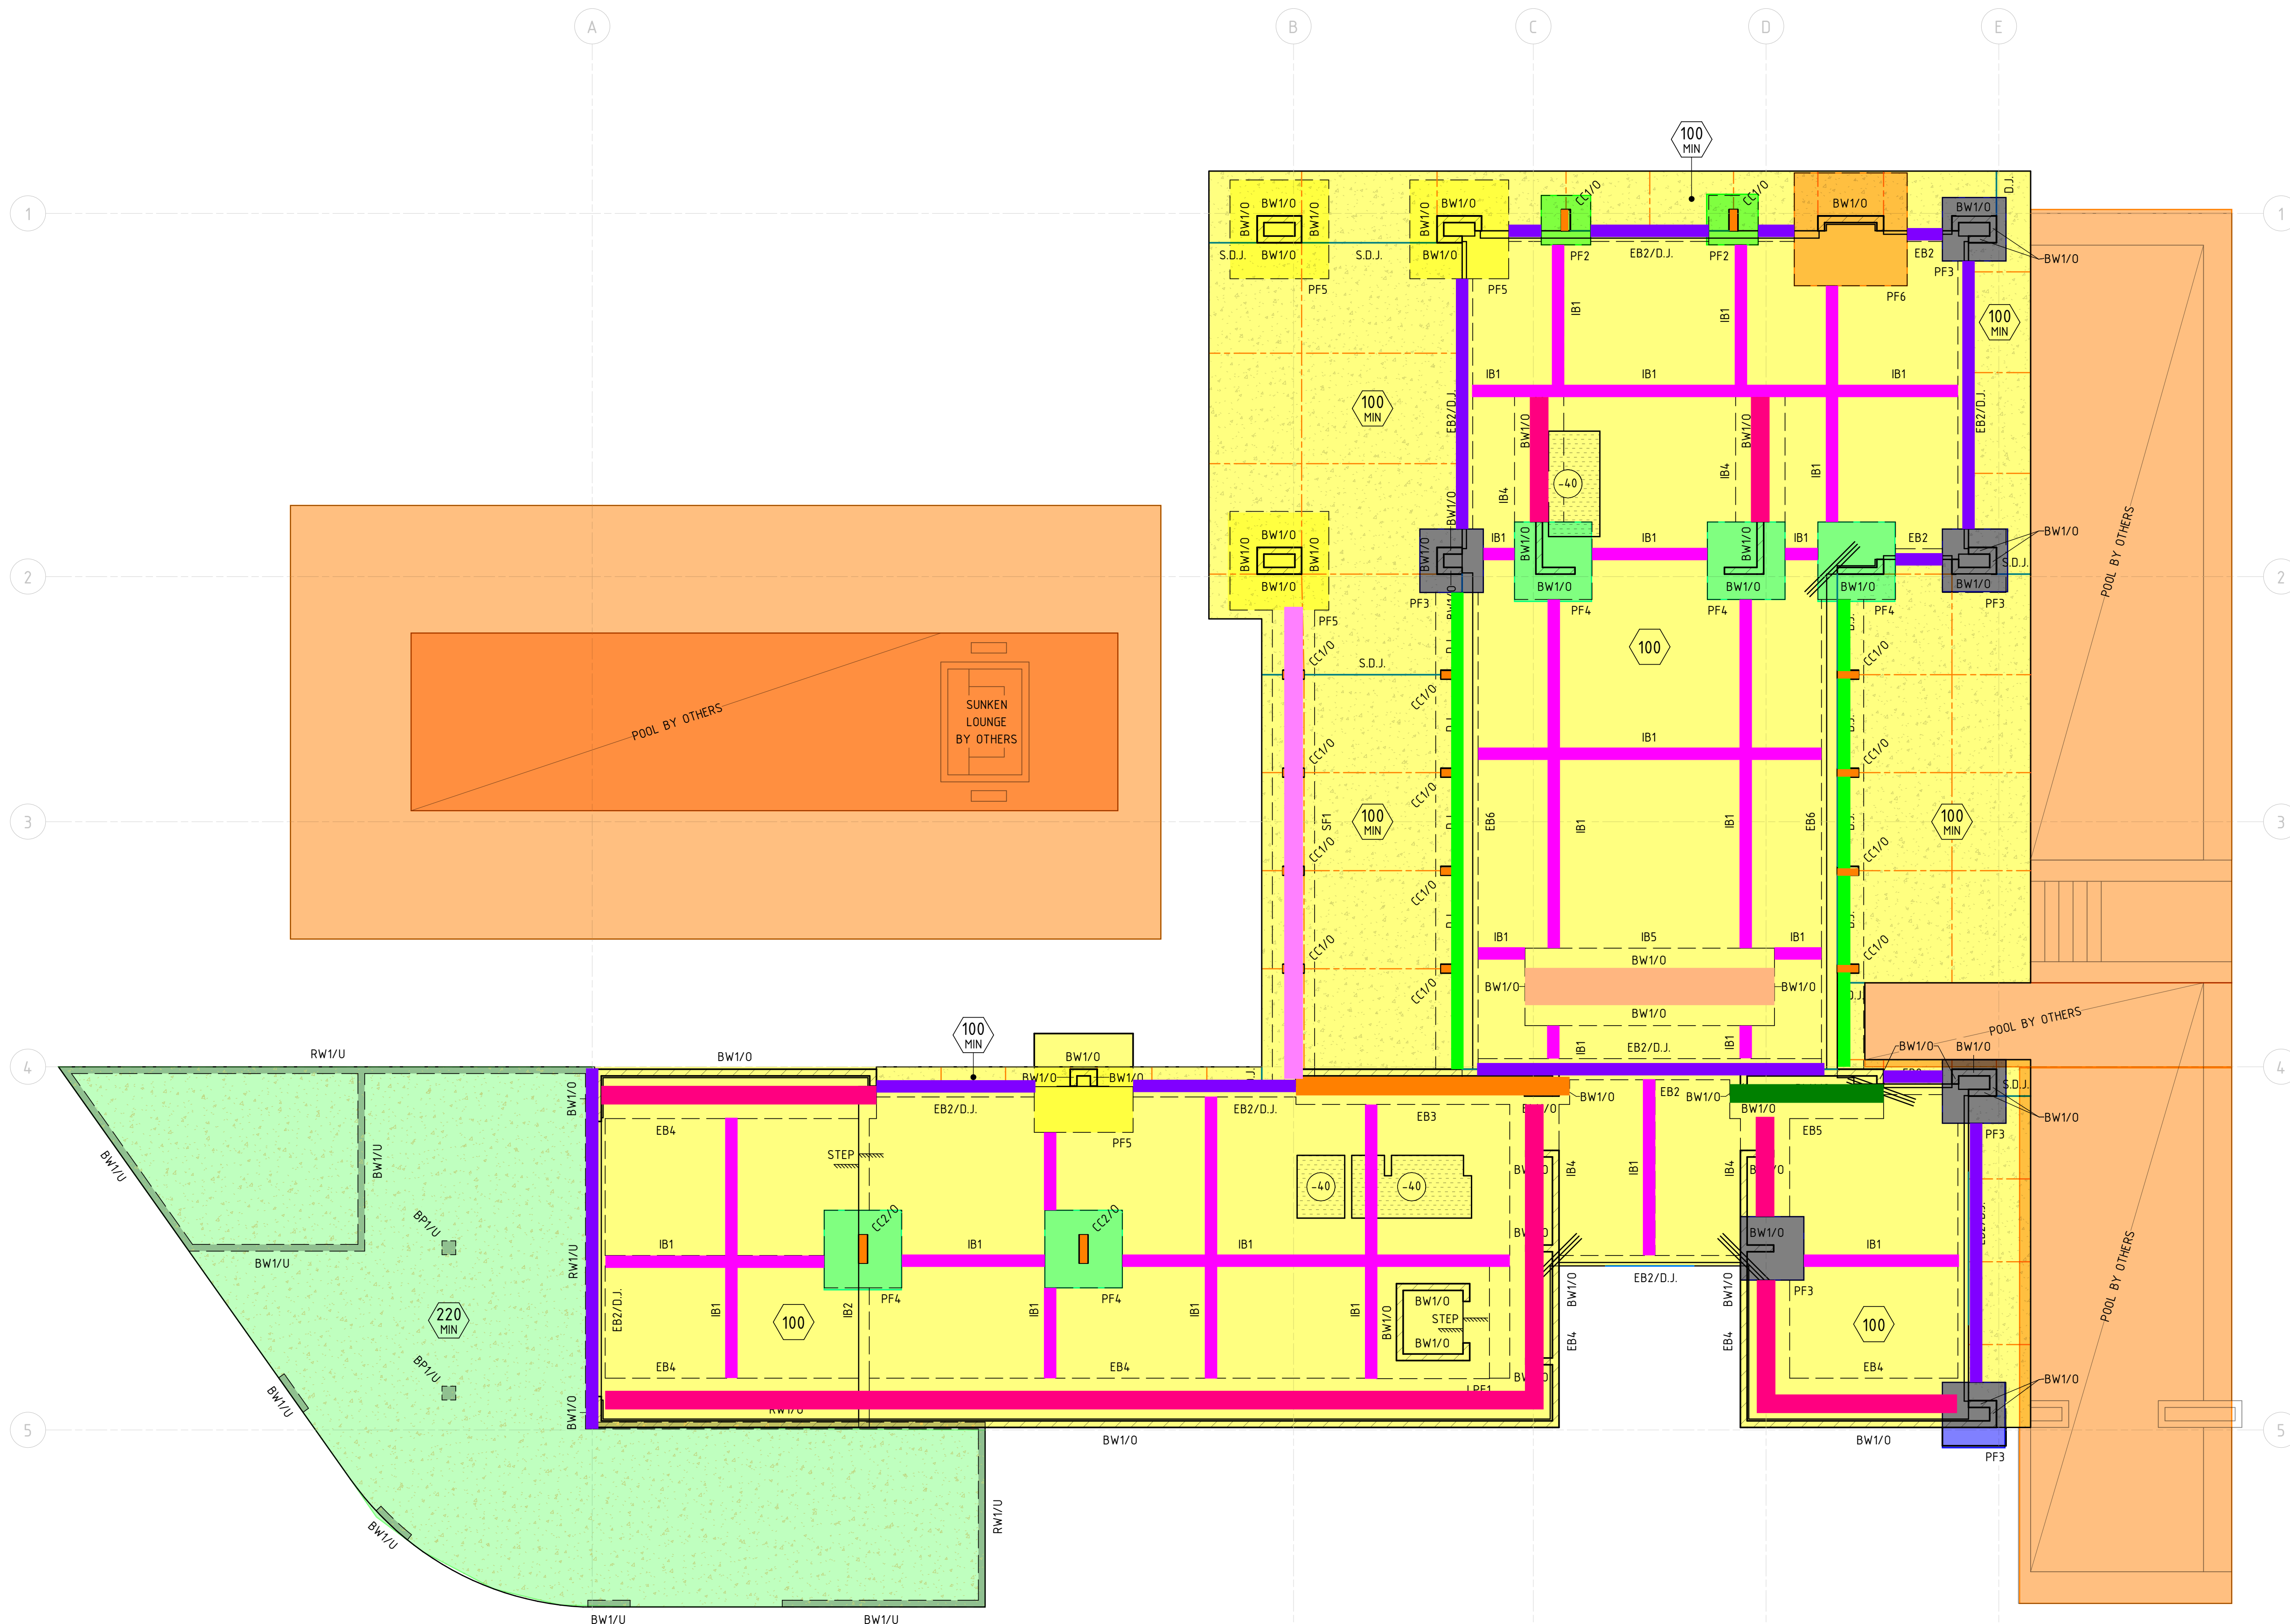[illegible]

GROUND FLOOR SLAB PLAN

NOT FOR CONSTRUCTION

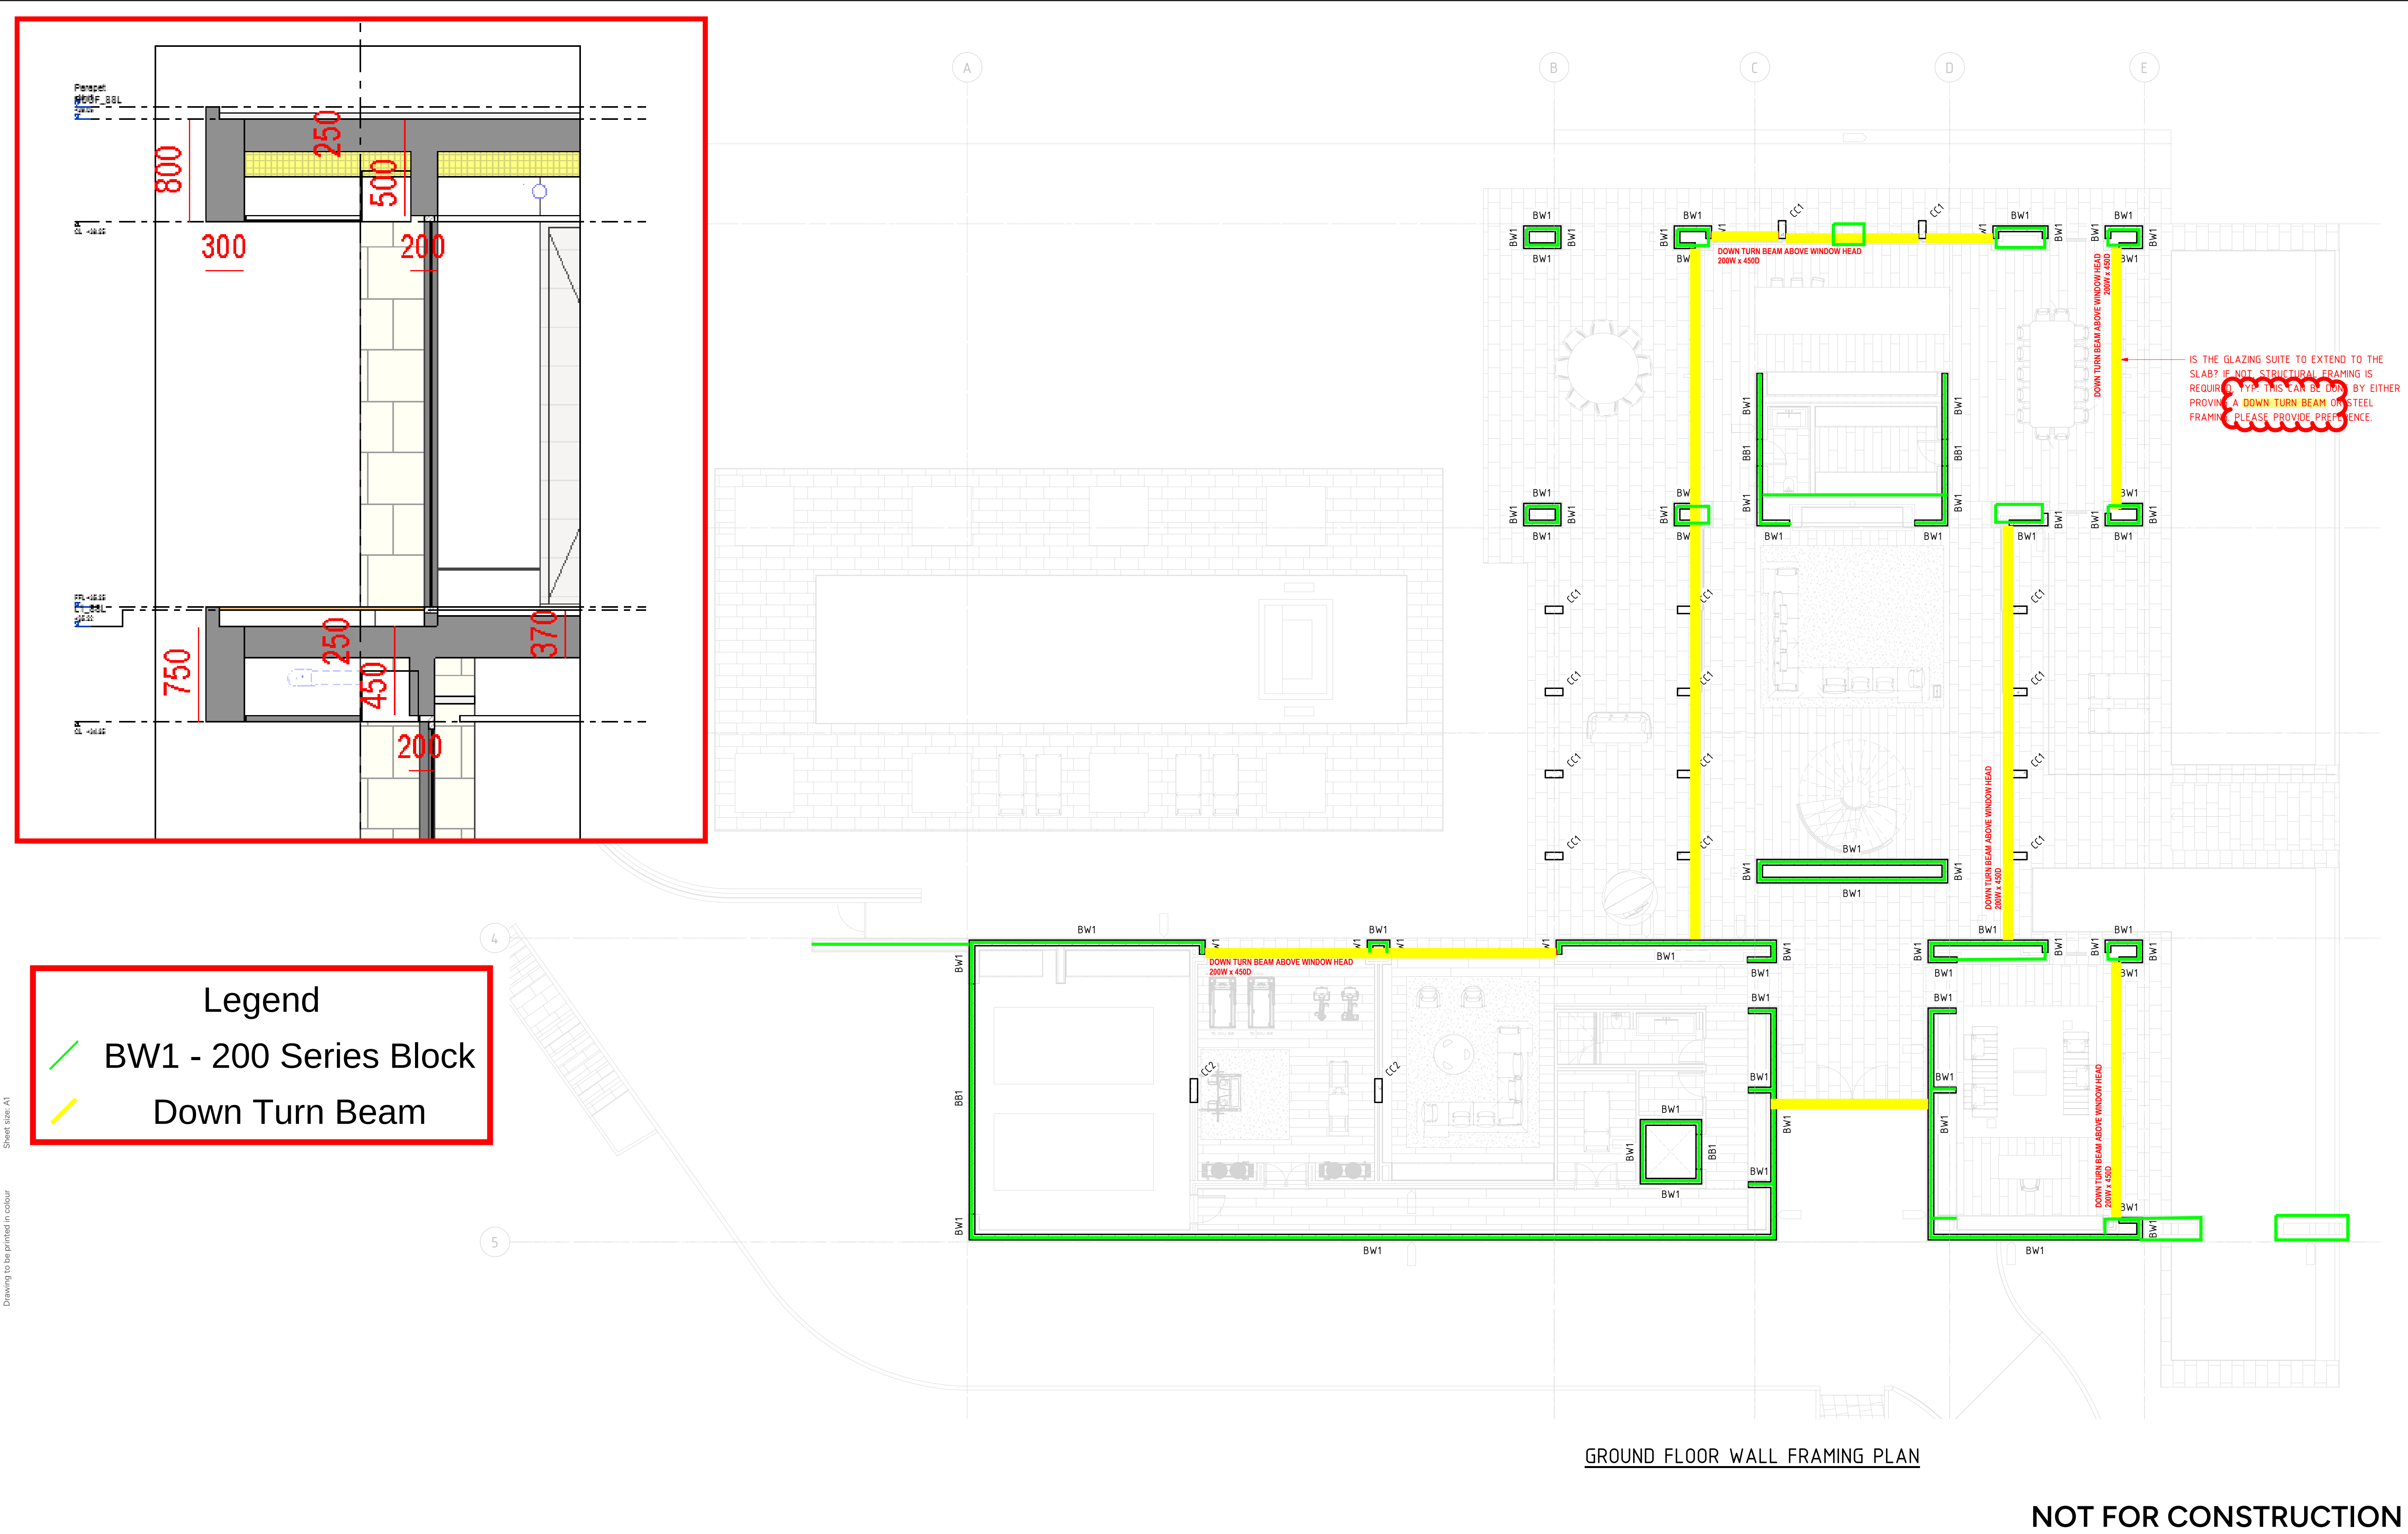



Legend

- BW1 - 200 Series Block
- Down Turn Beam

IS THE GLAZING SUITE TO EXTEND TO THE SLAB? IF NOT, STRUCTURAL FRAMING IS REQUIRED. IF YES, THIS CAN BE DONE BY EITHER PROVIDING A DOWN TURN BEAM OR STEEL FRAMING. PLEASE PROVIDE PREFERENCE.


GROUND FLOOR WALL FRAMING PLAN

NOT FOR CONSTRUCTION

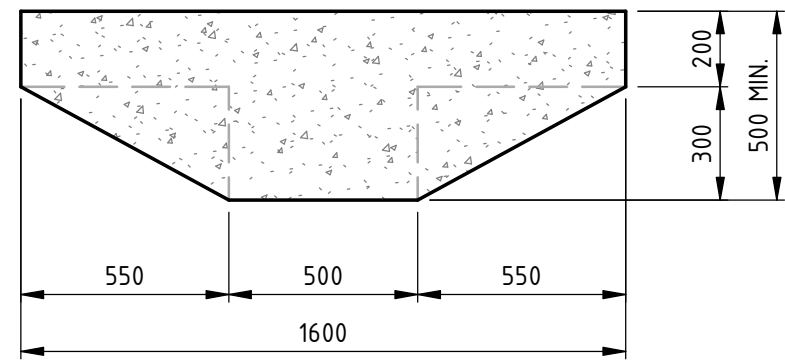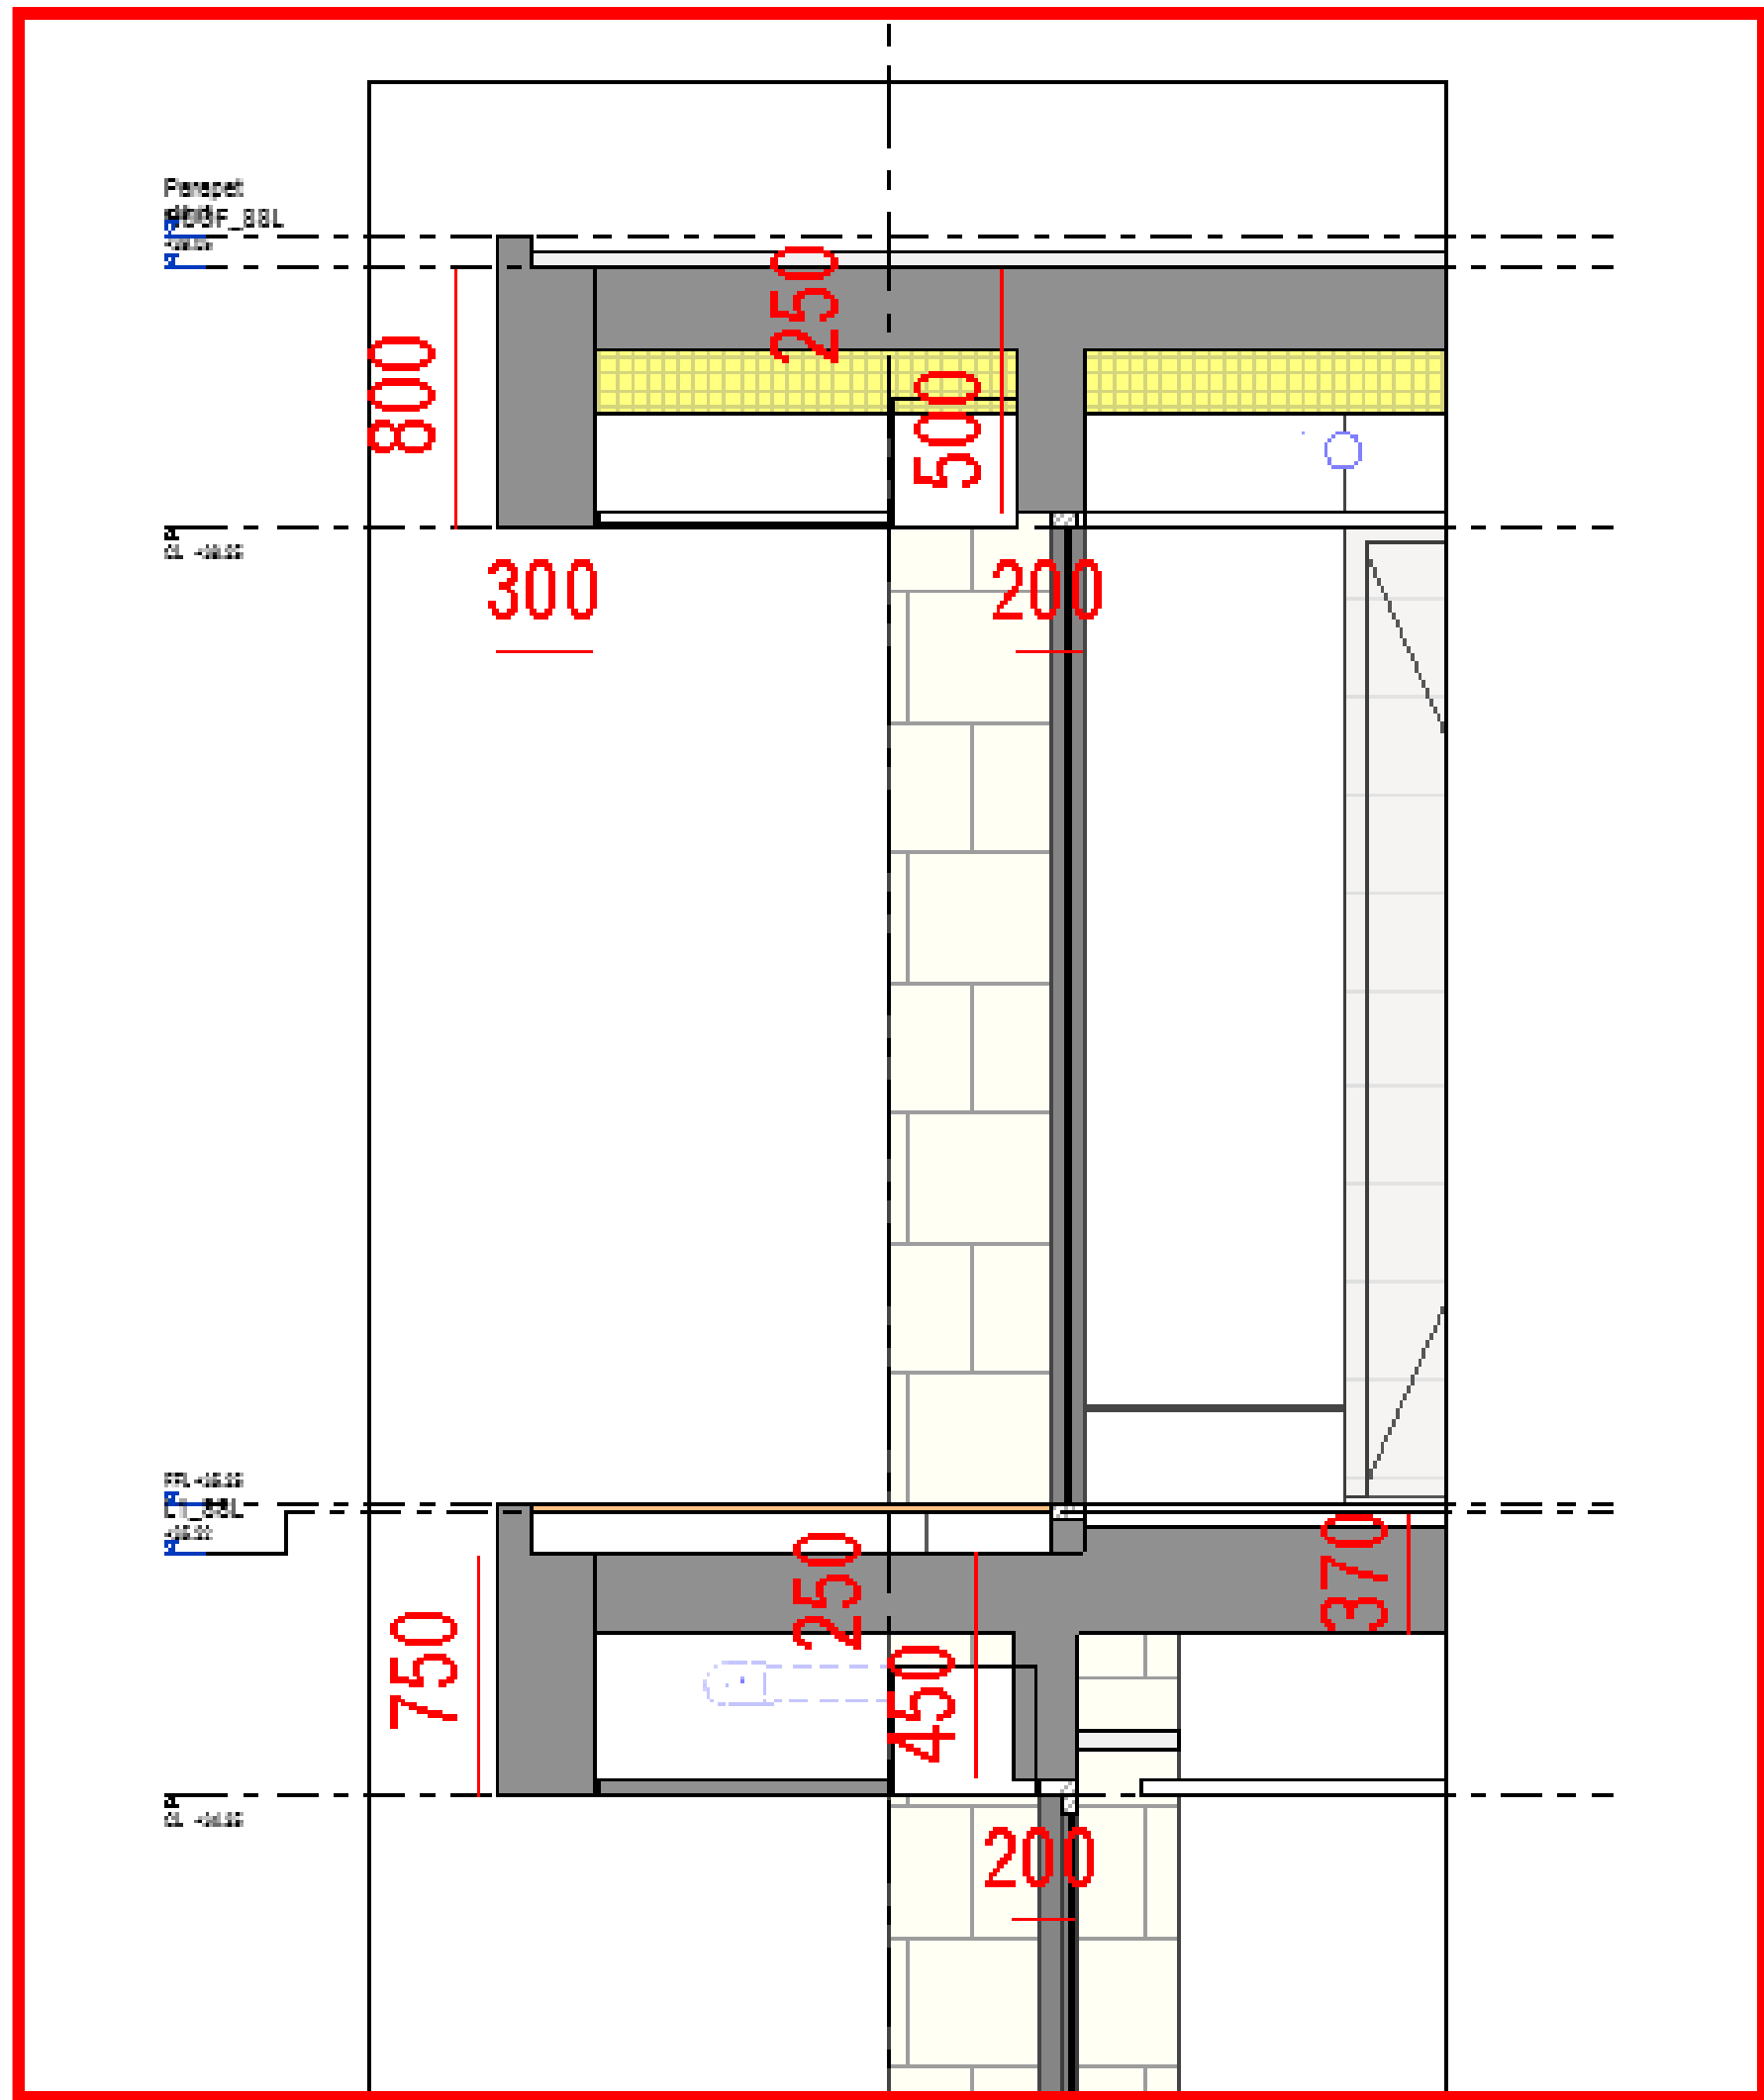

SECTION S1

120 BALCONY SETDOWN, 370mm FOLDS

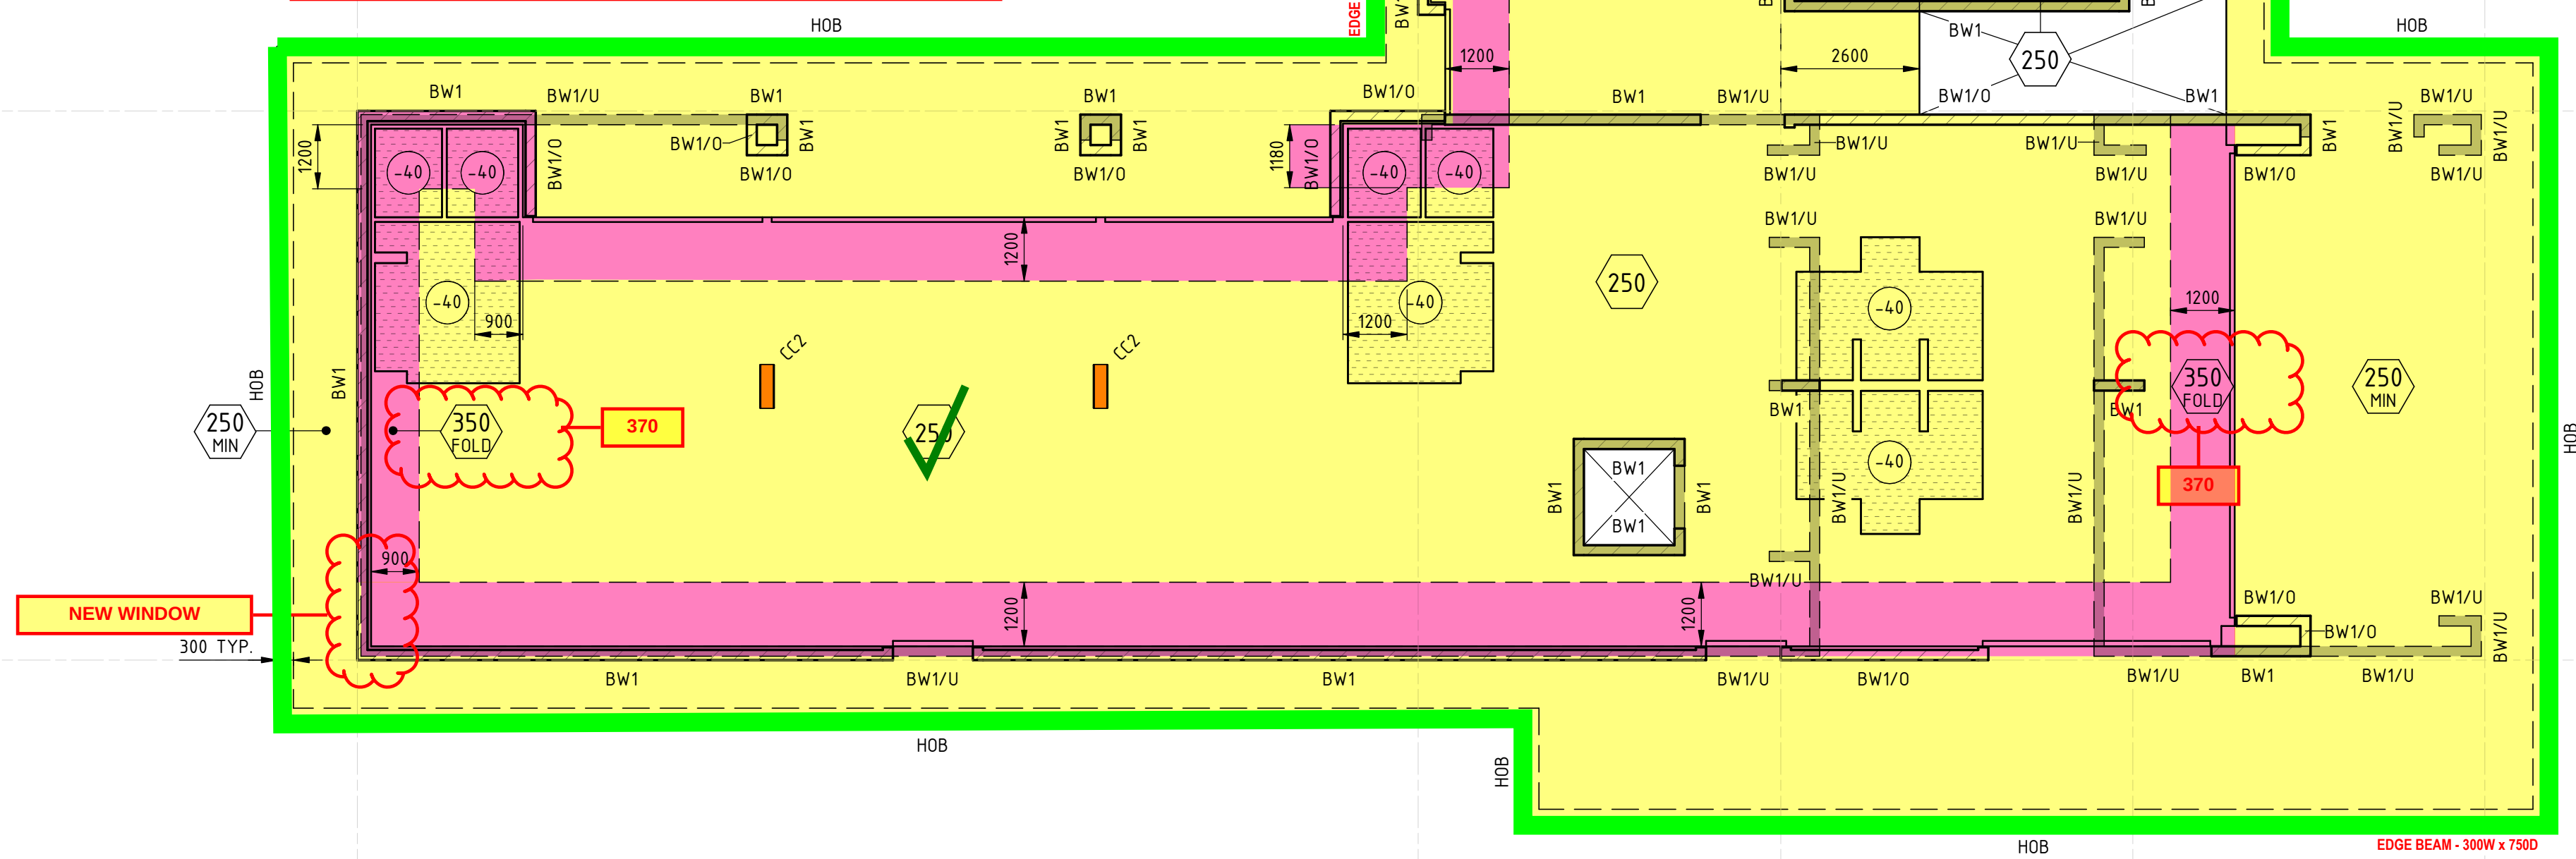

FIRST FLOOR SLAB PLAN

NOT FOR CONSTRUCTION

PROJECT
PROPOSED RESIDENTIAL DWELLING


DRAWING
FIRST FLOOR SLAB PLAN

JOB No.
ST250138

DRAWING No.
S04.01

REV.


1

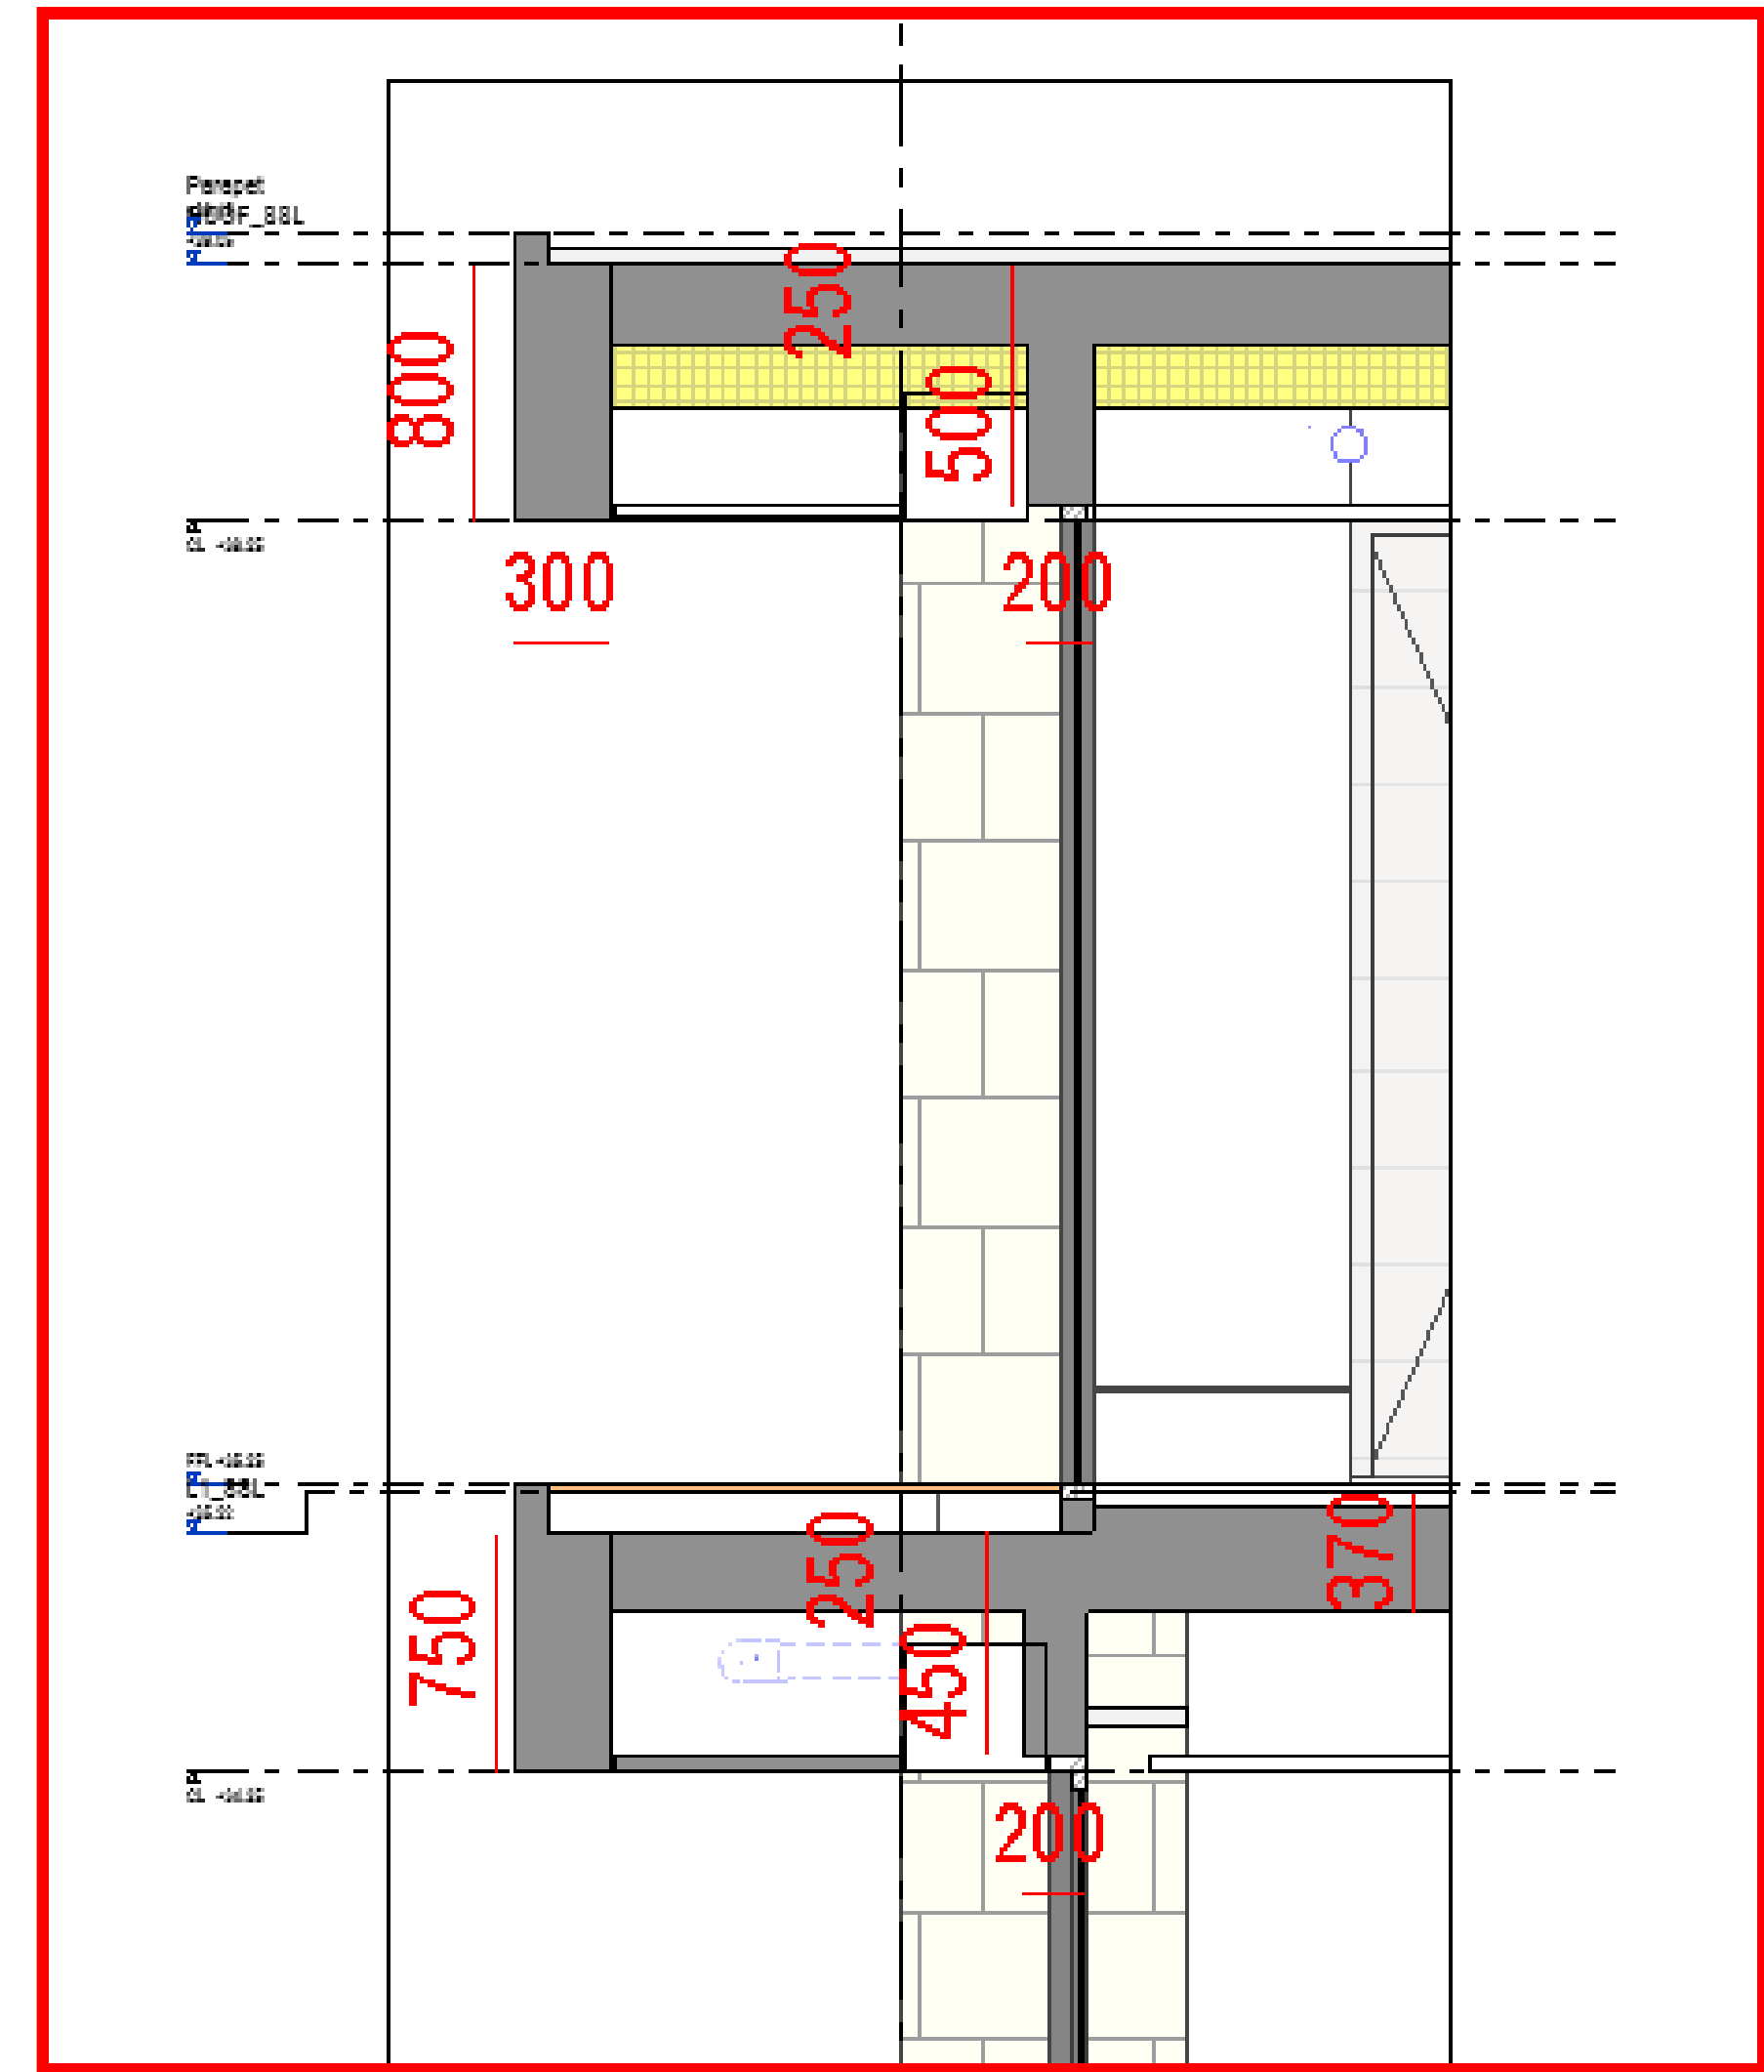

Legend

BW1 - 200 Series Block

Down Turn Beam

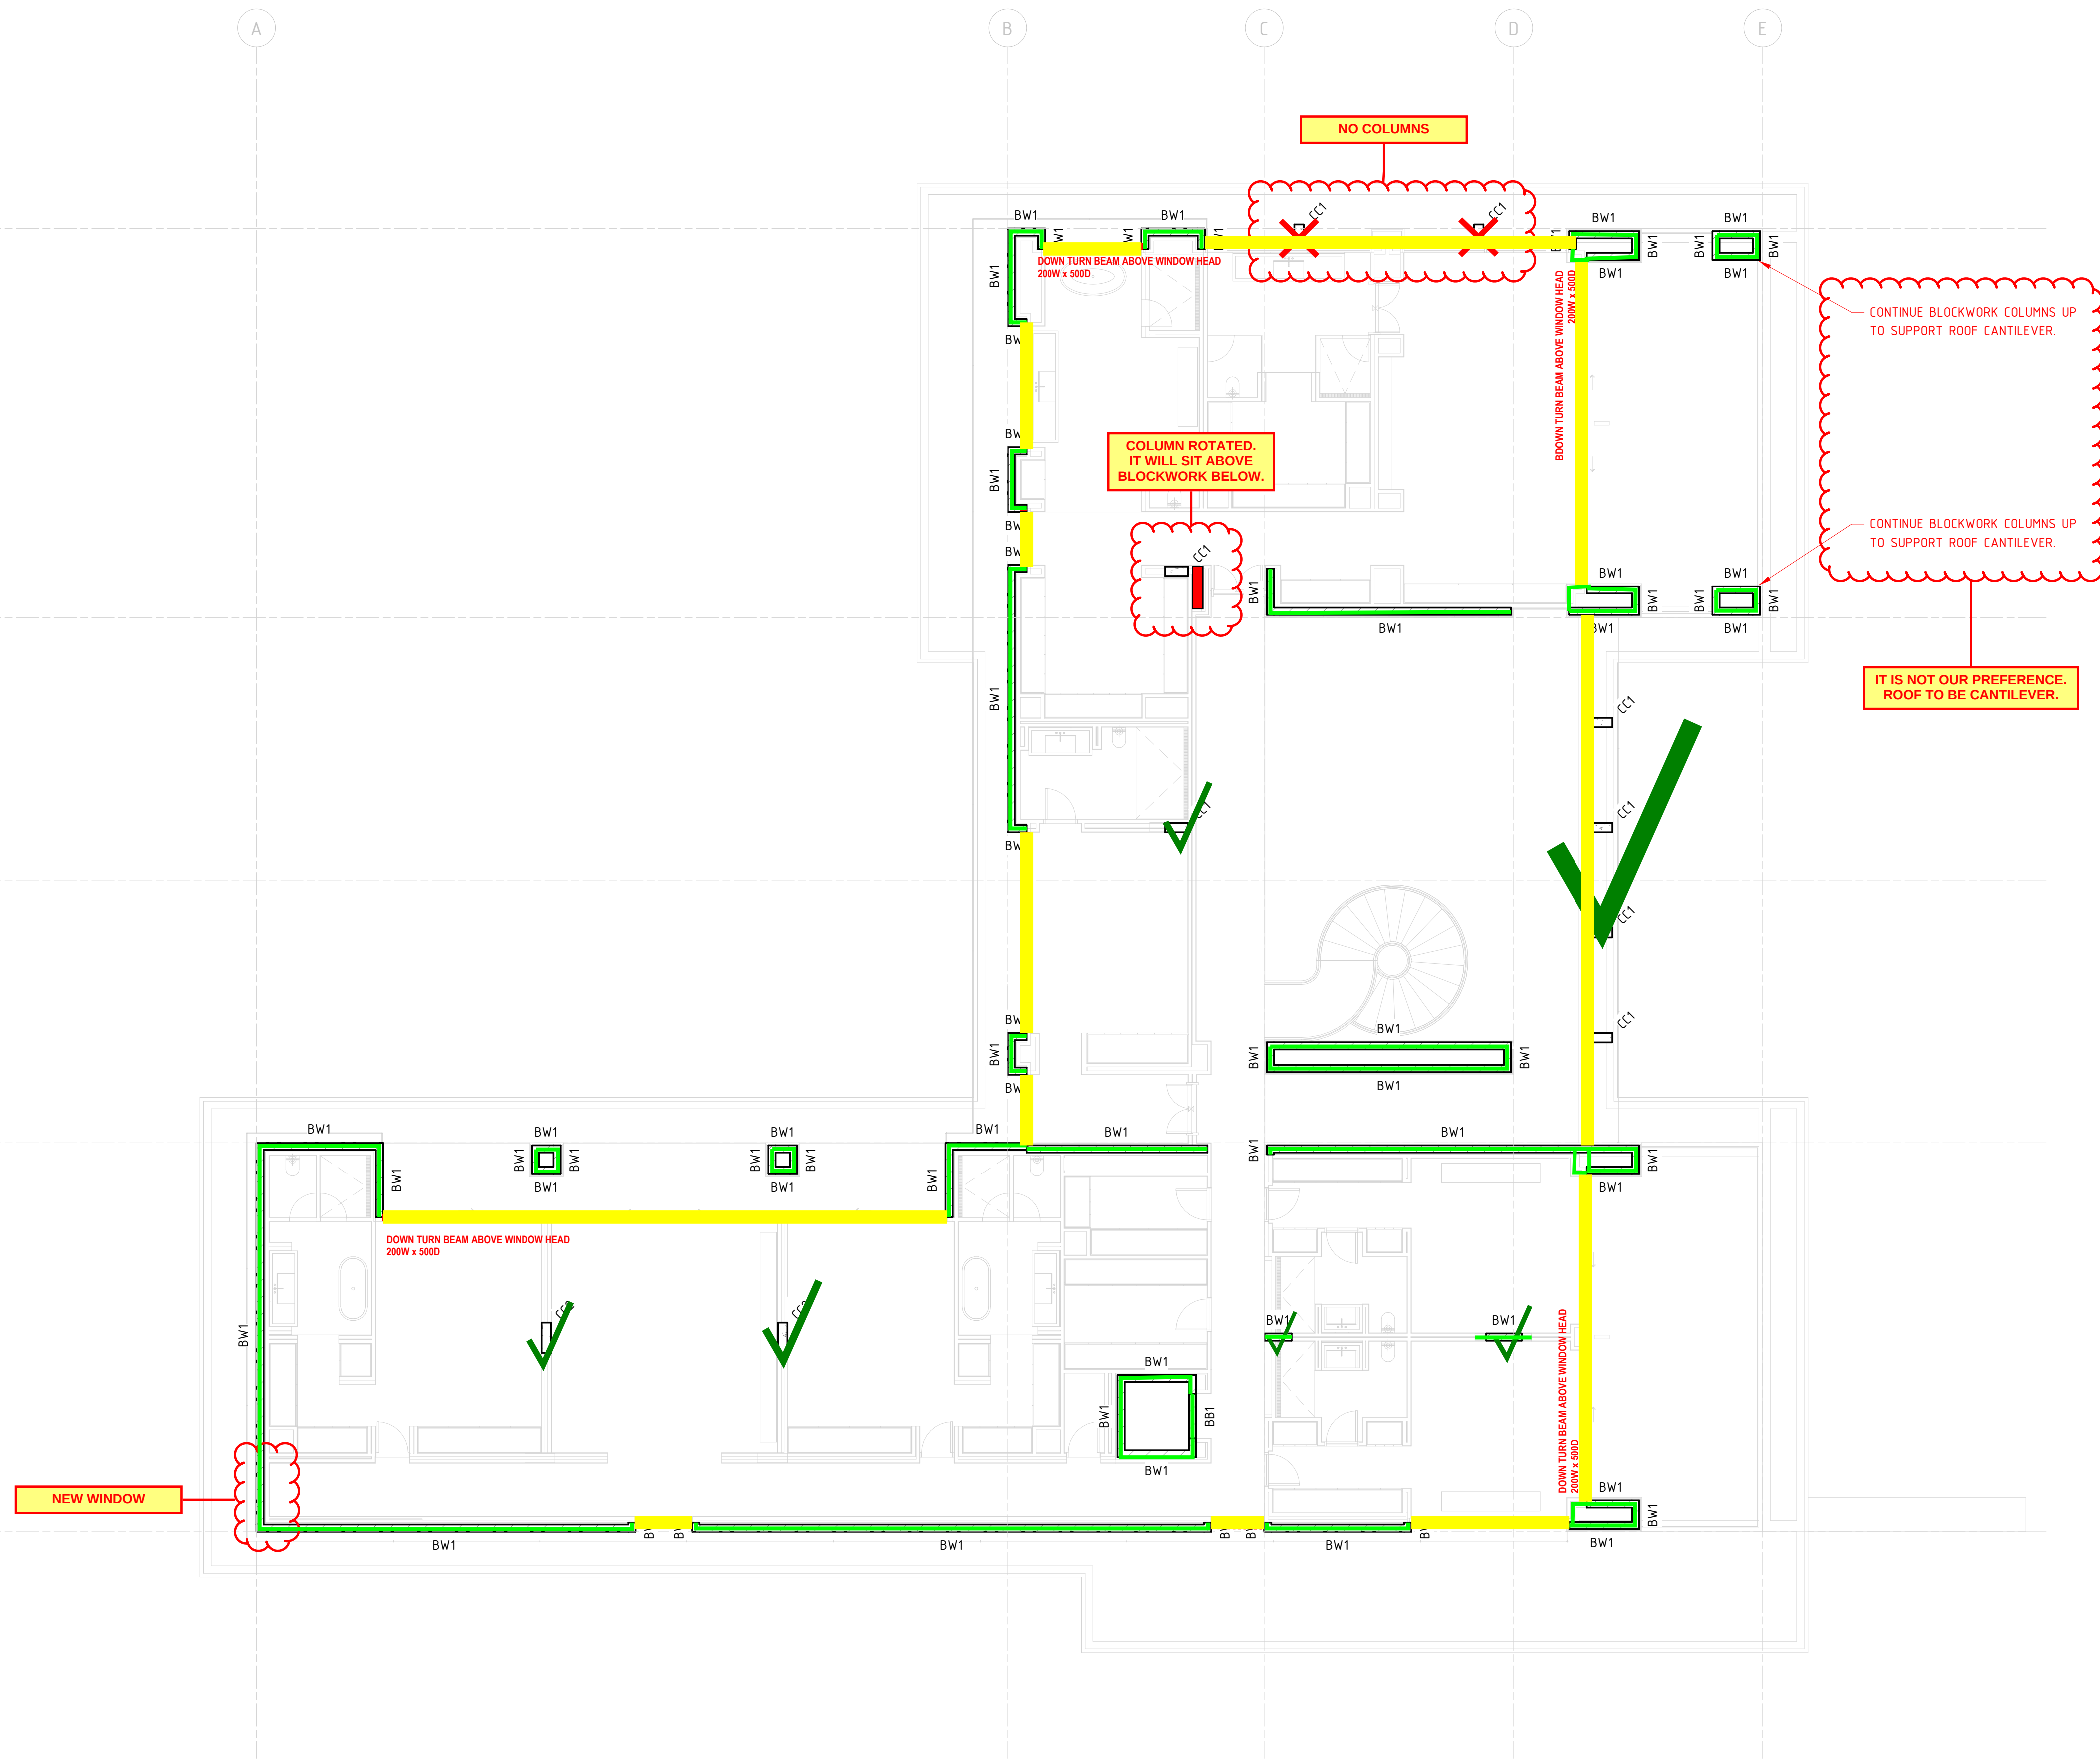

FIRST FLOOR WALL FRAMING PLAN

NOT FOR CONSTRUCTION

NOTES


FOR SPECIFICATION NOTES, REFER TO DRAWINGS S00.01 – S00.04.


THESE DRAWINGS SHALL BE READ IN CONJUNCTION WITH THE LATEST ARCHITECT'S DRAWINGS AND ANY RELEVANT CONSULTANT'S / CONTRACTOR'S DRAWINGS. IT IS THE BUILDERS RESPONSIBILITY TO ENSURE THE LATEST REVISION OF ALL DRAWINGS ARE BEING USED ON SITE.


CO-ORDINATE ALL SERVICE PENETRATION SIZES AND LOCATIONS WITH MECHANICAL, ELECTRICAL AND HYDRAULIC CONSULTANT'S DRAWINGS.

LEGEND

- 

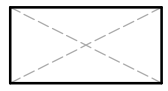DENOTES SUSPENDED CONVENTIONALLY REINFORCED SLAB THICKNESS, REFER PLANS FOR VARIATIONS IN DEPTH AND POST-TENSIONING NOTES FOR SPECIFICATION, 'MIN' DENOTES MINIMUM SLAB THICKNESS.
- 

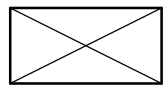DENOTES FALLS IN STRUCTURAL SLAB TO DRAINAGE, REFER ARCHITECTURAL CONCRETE SET-OUT PLANS FOR SPECIFICATION.
- 

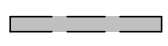DENOTES PENETRATIONS/VOIDS IN SUSPENDED CONCRETE SLAB. PROVIDE TRIMMERS BARS TO EDGES.
- 

DENOTES LOAD-BEARING STRUCTURAL ELEMENT UNDER.
- * / O DENOTES STRUCTURAL MEMBER OVER.

* / U DENOTES STRUCTURAL MEMBER UNDER.


VERTICAL STRUCTURAL ELEMENTS WITHOUT A SUFFIX (* / O OR * / U) SHALL BE READ AS OVER & UNDER. REFER TO MEMBER SCHEDULE FOR ADDITIONAL INFORMATION.

- ROOF SLAB SCHEDULE -		
	SIZE	COMMENTS
CONCRETE COLUMN		
CC1	250 x 600	
CC2	250 x 800	
HOB		
HOB	TO FUTURE DETAIL	
LOAD-BEARING BLOCKWORK WALL		
BW1	190	

Legend

Concrete Slab - 250mm THK

Edge Beam - 200x800mm

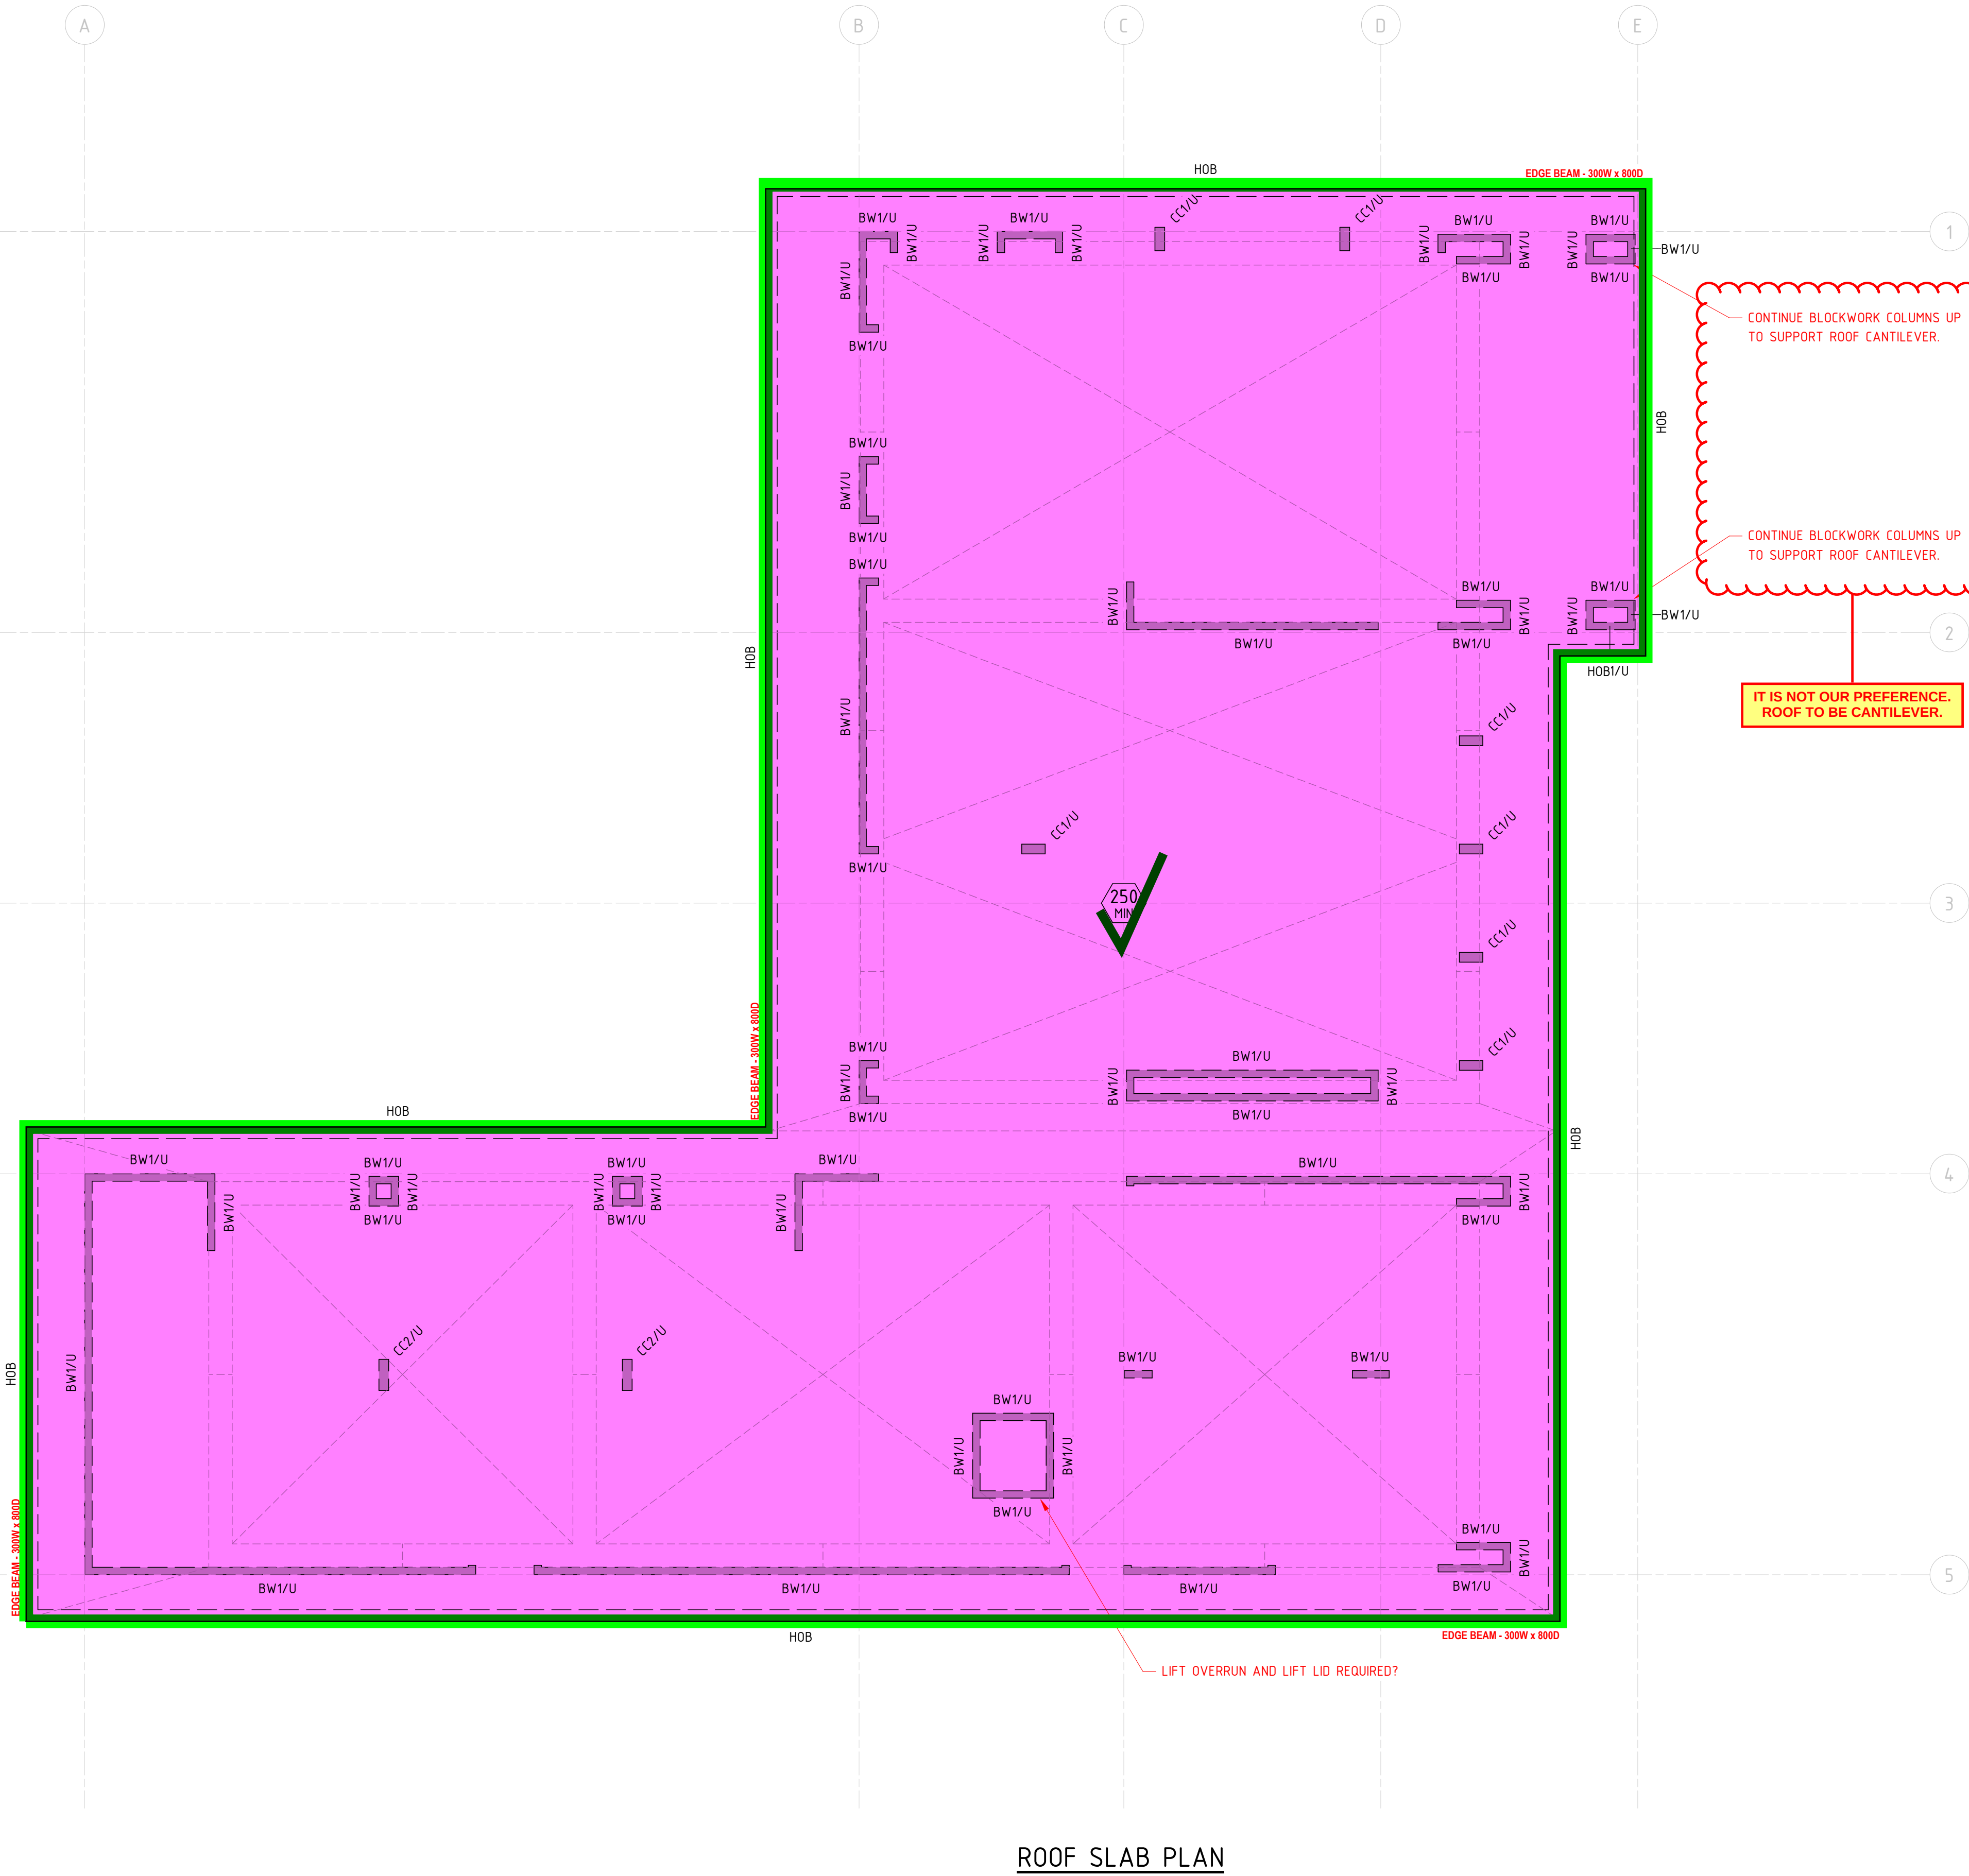

ROOF SLAB PLAN

NOT FOR CONSTRUCTION